


STEVE HAWLEY LANE WATER & SANITARY SEWER

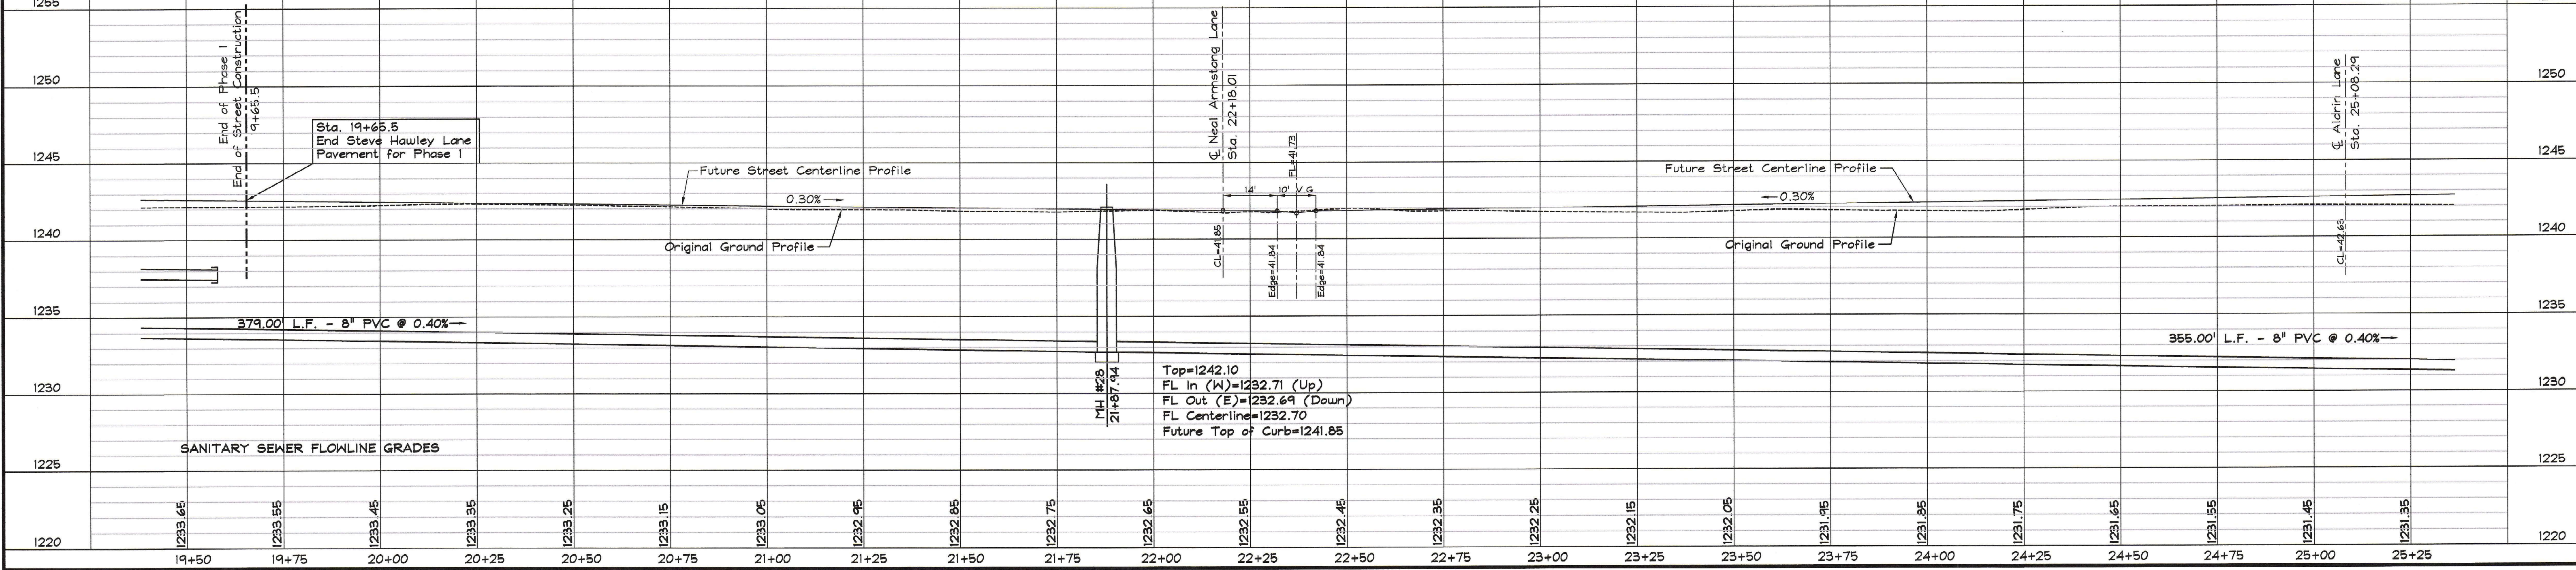

STEVE HAWLEY - WATER & SEWER