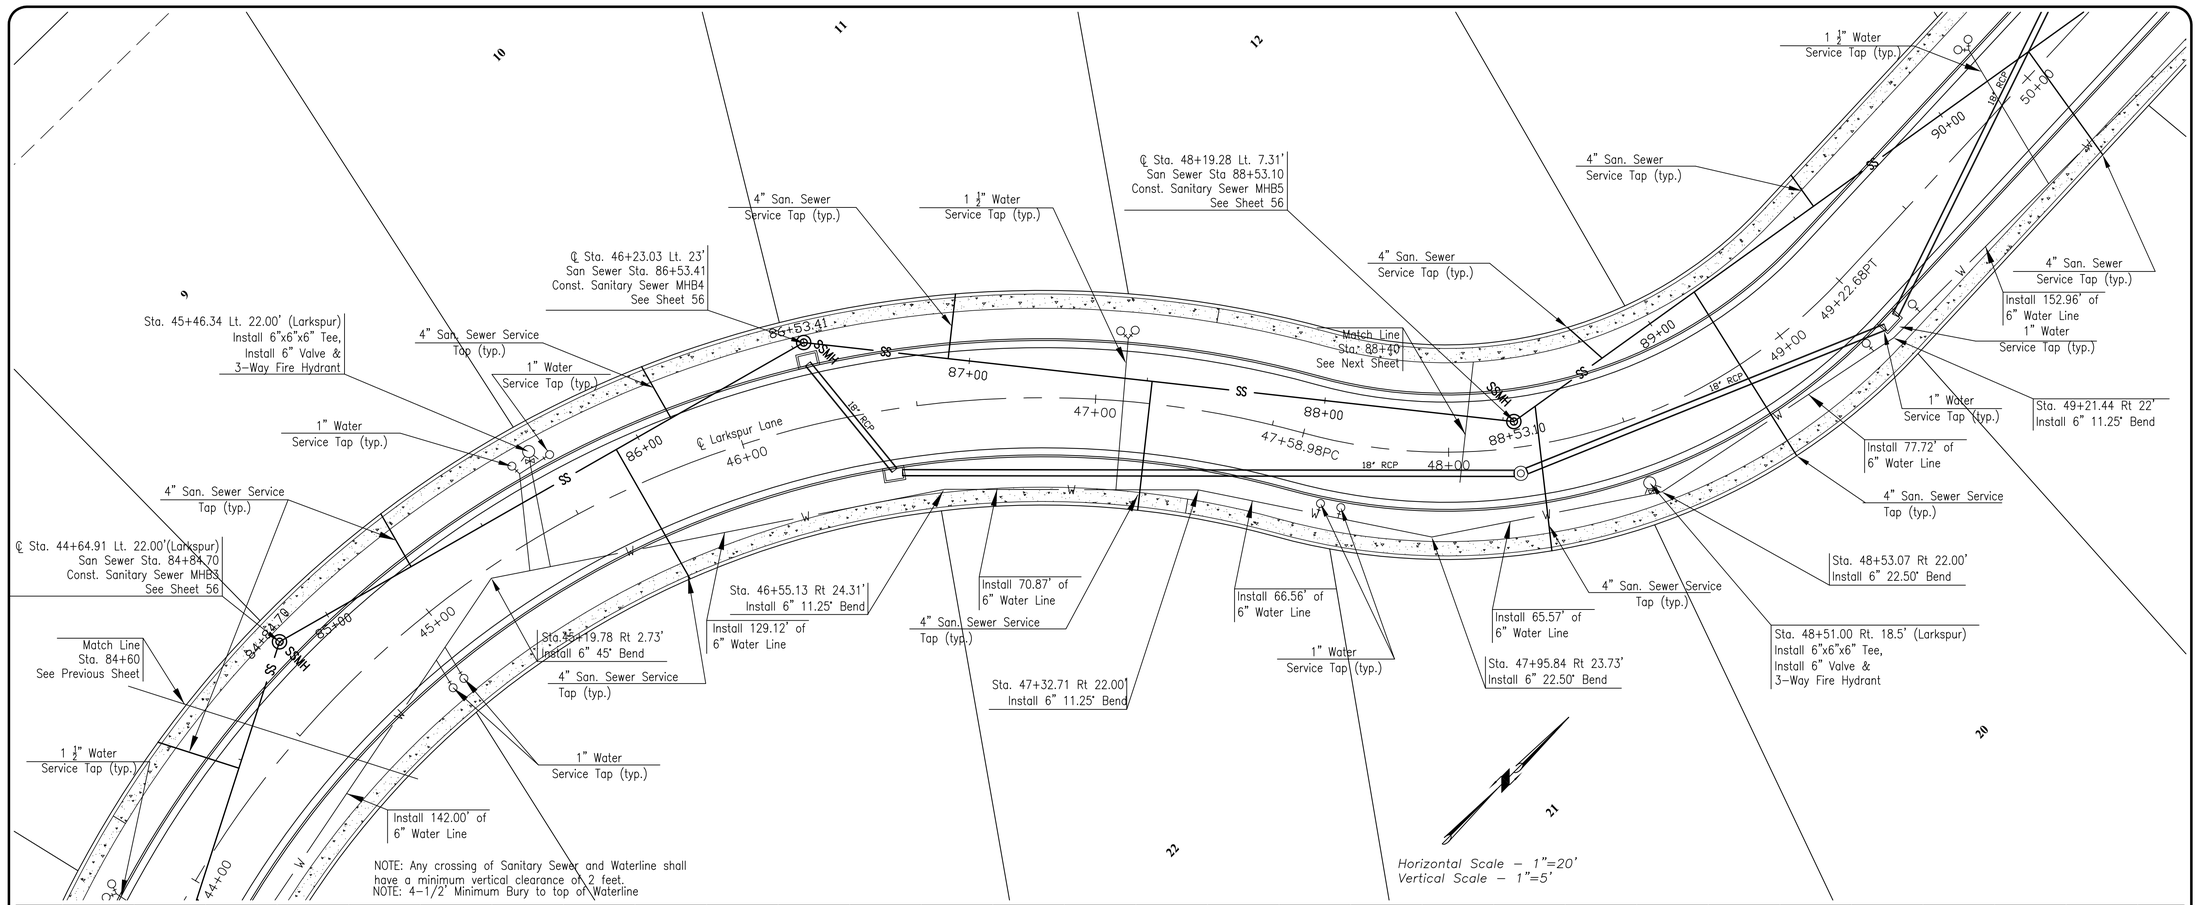

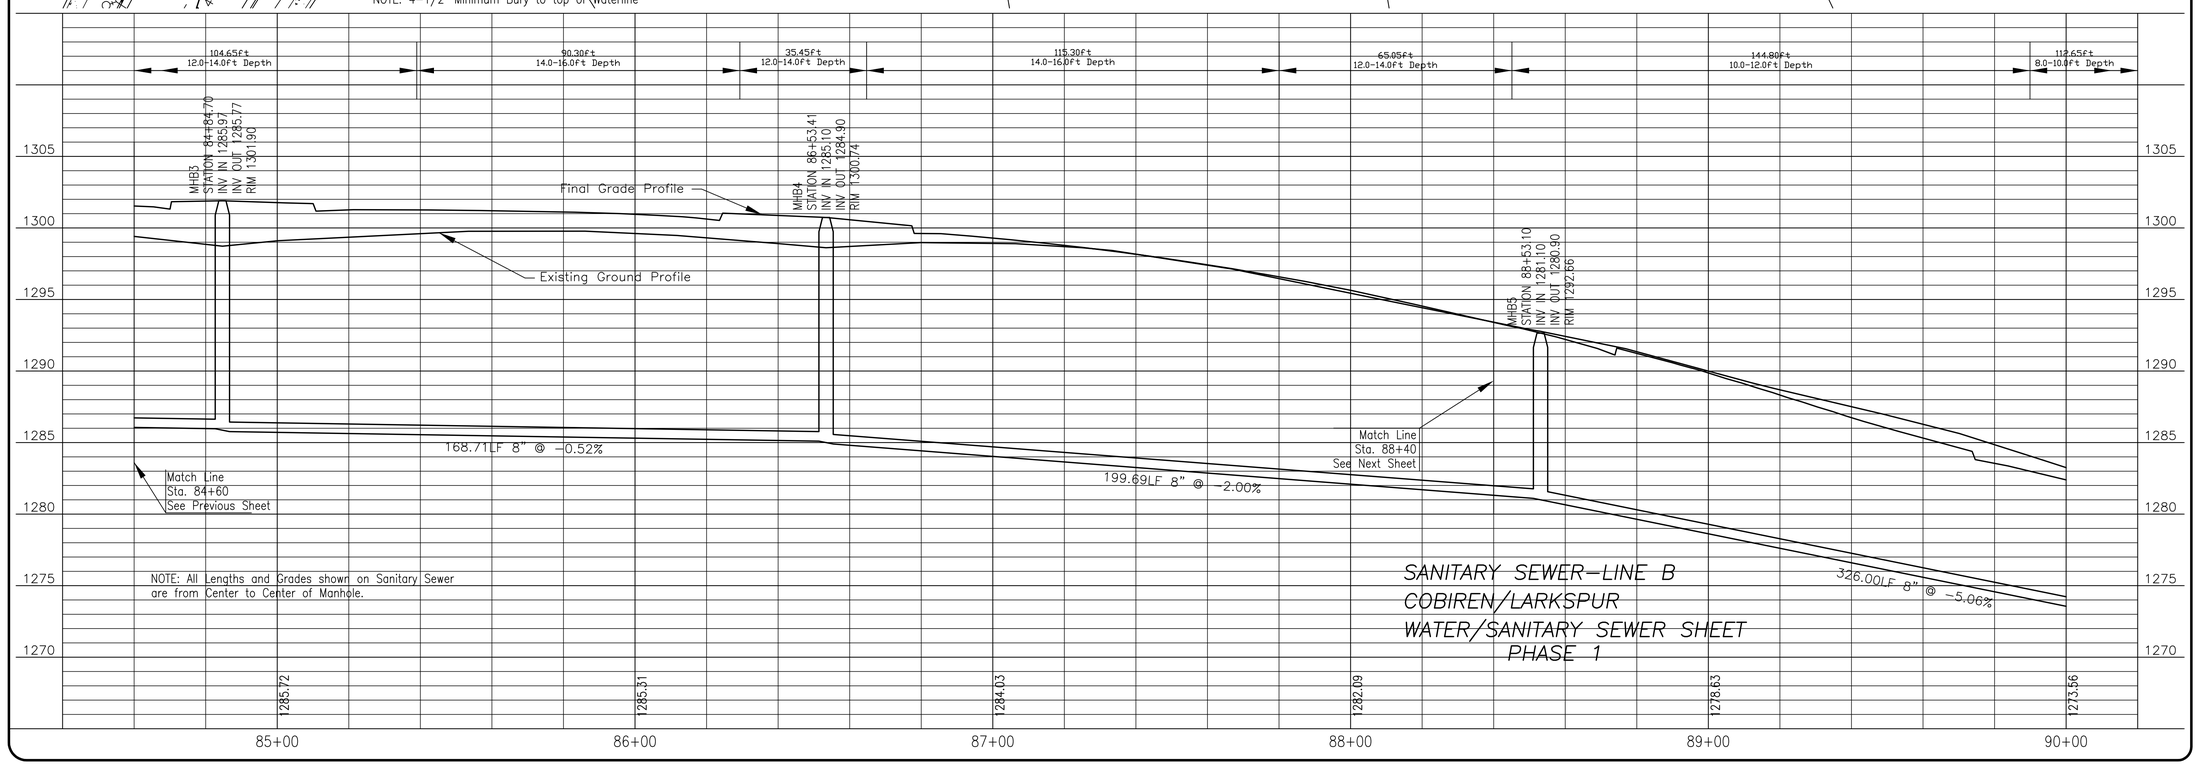

NOTE: All Lengths and Grades shown on Sanitary Sewer are from Center to Center of Manhole.

SANITARY SEWER-LINE B
COBIREN/LARKSPUR
WATER/SANITARY SEWER SHEET
PHASE 1

REVISIONS

Waterline/San Sewer Sheet
Grand Prairie Addition
City of Salina, KS

CAMPBELL & JOHNSON ENGINEERS, P.A.
ENGINEERS • ARCHITECTS • LAND SURVEYORS
785-243-1735 CONCORDIA, KANSAS • JUNCTION CITY, KANSAS 866-720-1735

DRAWN	GLA
CHECKED	DND
DATE	10/16/2009
SCALE	1" = 20'
JOB NO.	07074
SHEET	36/77